




4 OIL LUBE RACK DETAIL  
SCALE 3/8" = 1'-0"

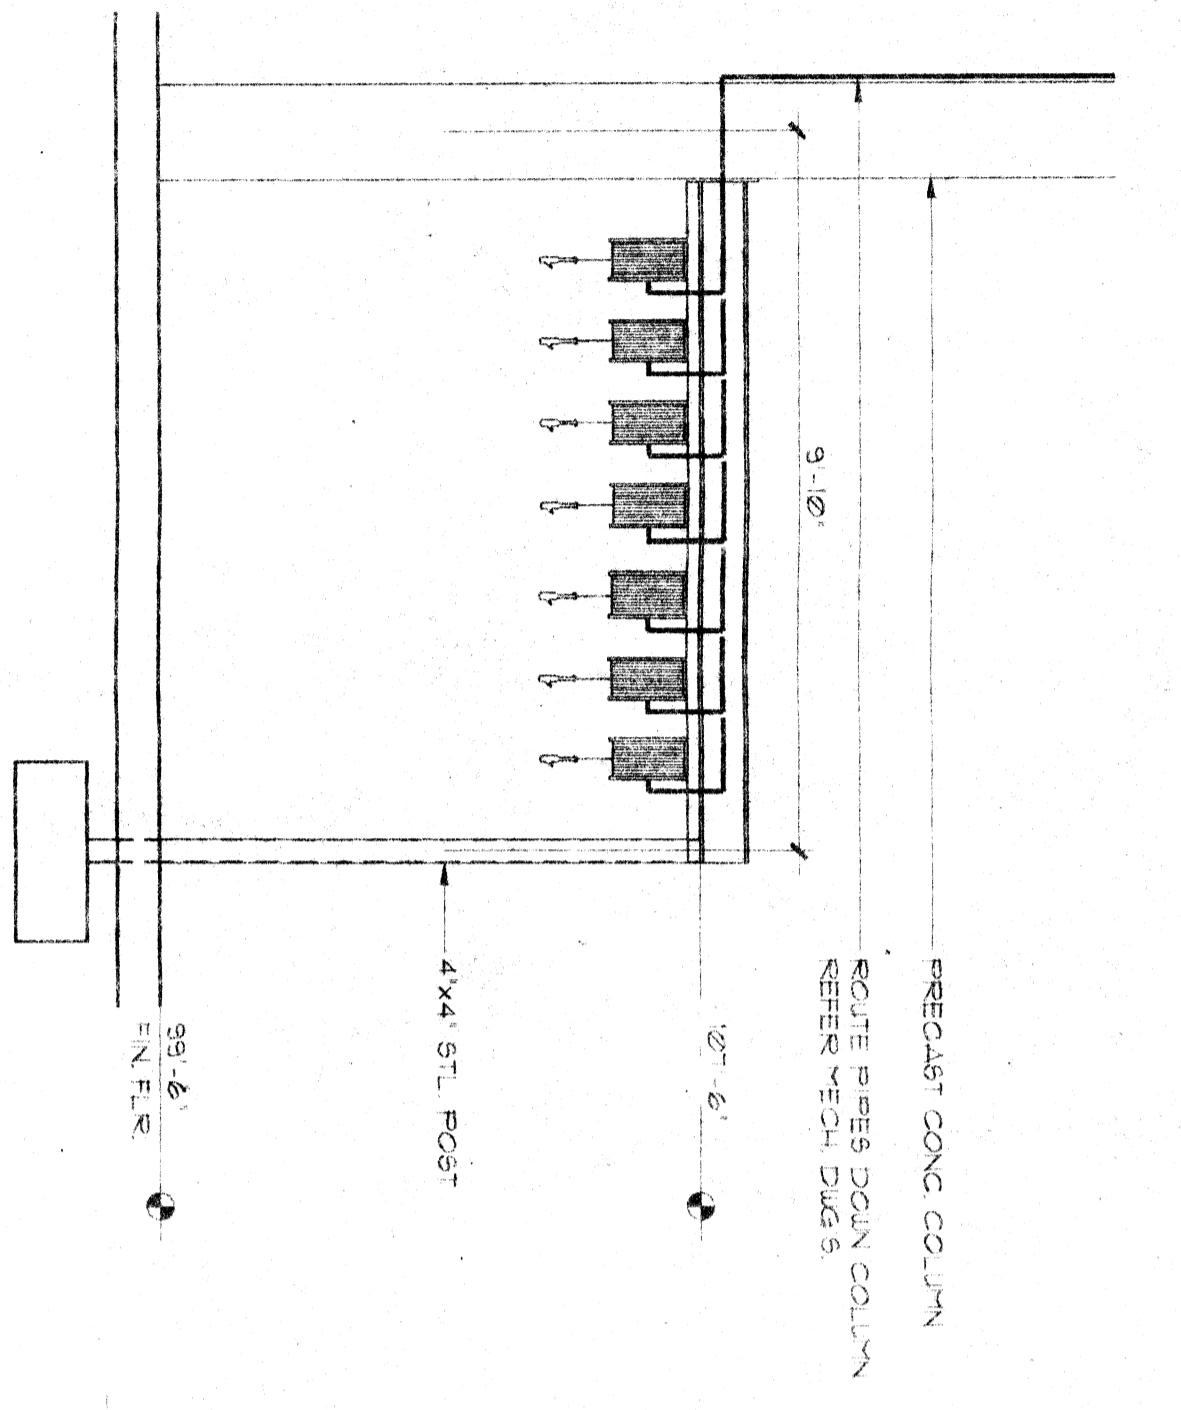


3 WALL SECTION  
SCALE 3/8" = 1'-0"

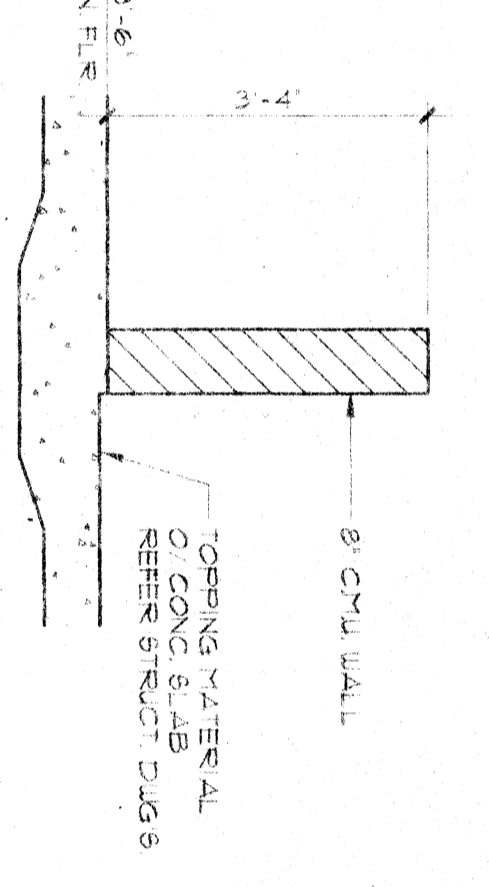

2 ENLARGED ENTRY PLAN  
SCALE 1/4" = 1'-0"

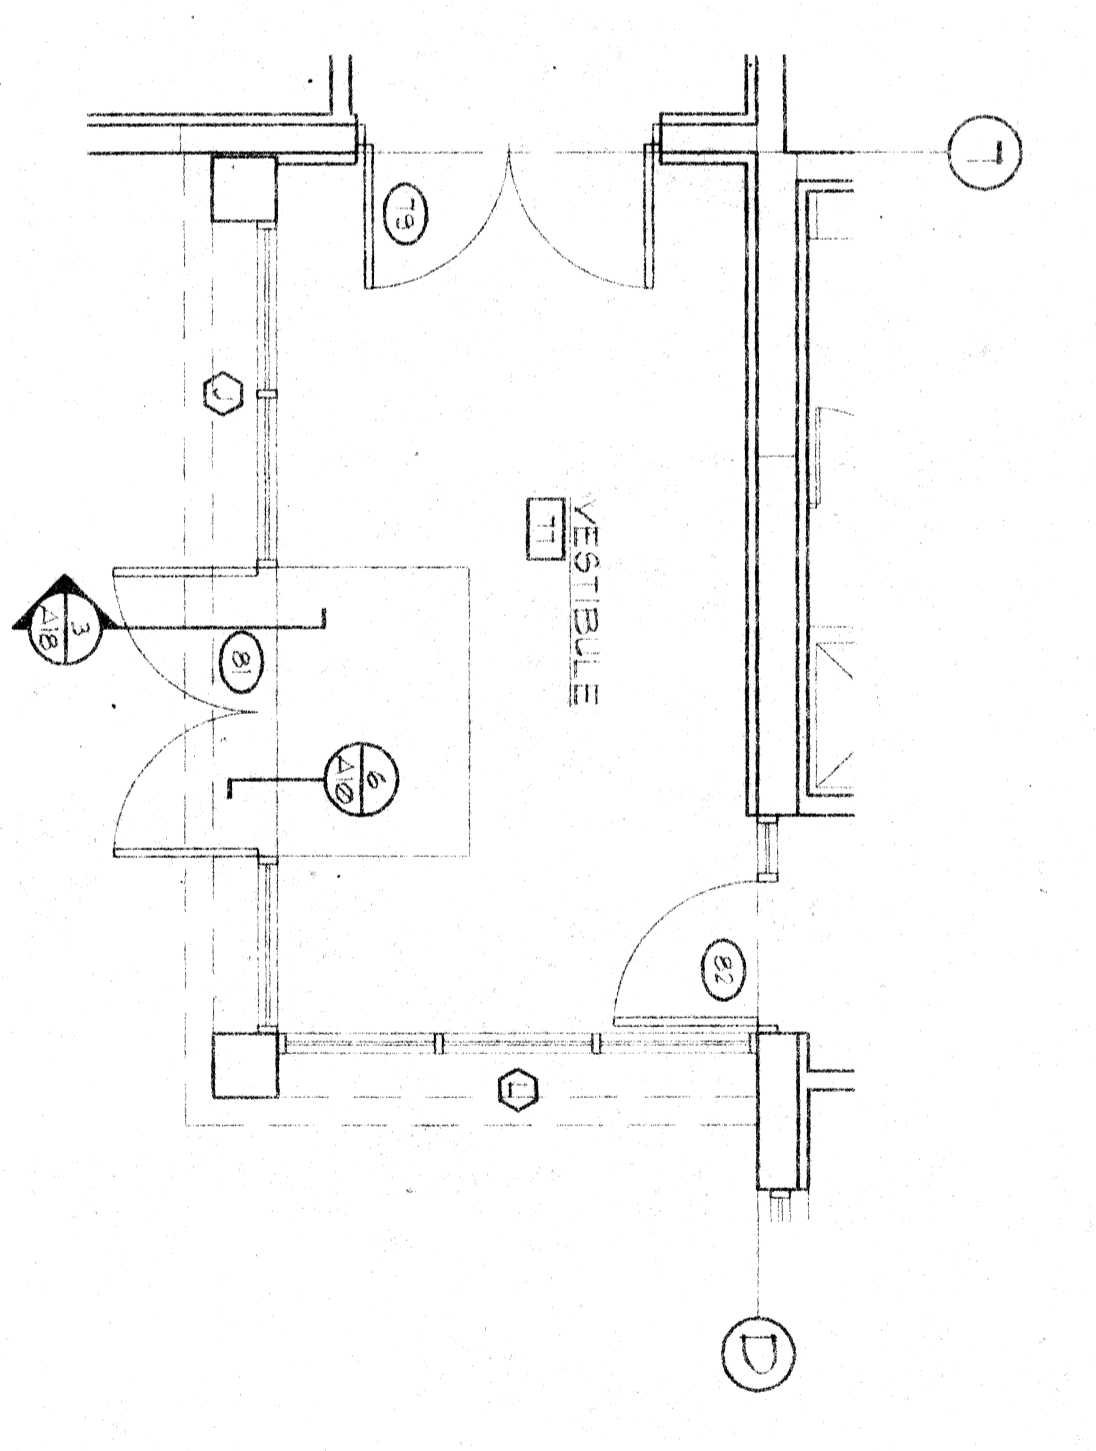


1 ENLARGED ENTRY PLAN  
SCALE 1/4" = 1'-0"

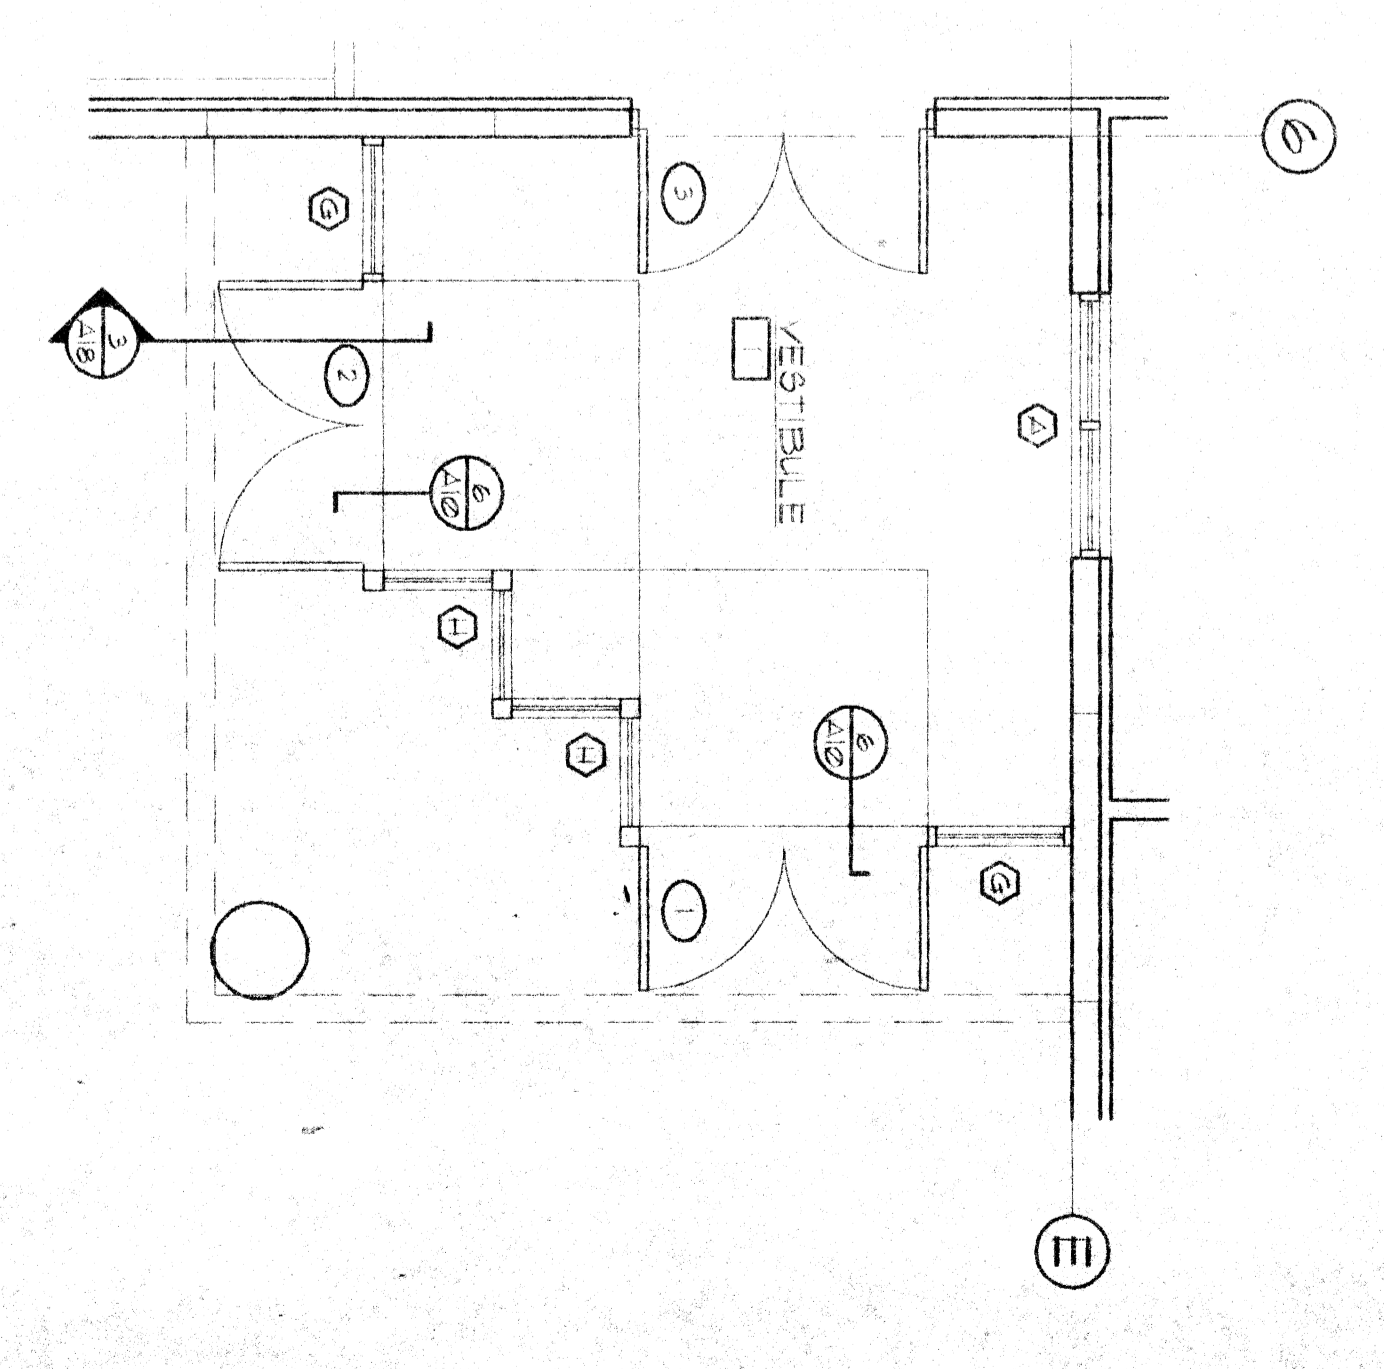


HILTIEN CABINET	COLOR
8021	4 BLACKLINE
2531	453158

FIRST FLOOR PLAN  
SCALE 1/8" = 1'-0"

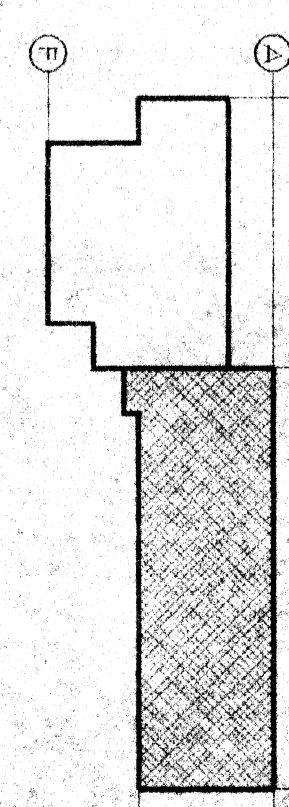

REVISIONS:  
LOCATED FE 9/18/95  
ADDED WALLS 9/18/95  
AS-BUILT 10/21/98

EL PASO COUNTY  
DEPARTMENT OF TRANSPORTATION  
MARKSHEFFEL ROAD  
COLORADO SPRINGS, COLORADO

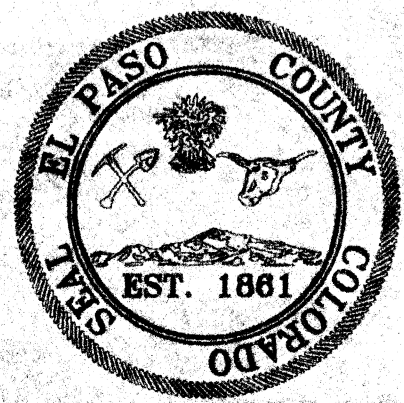

**JWN**  
& associates

James W. Nadel, C.  
105 East Wornon Avenue  
Suite 200  
Colorado Springs  
Tel: (719) 535-2142

DRAWN BY: RKH/W  
CHECKED BY: RAS  
DATE: 7/6/95  
SCALE: AS NOTED  
JOB NUMBER: 93308  
SHEET NUMBER: A-3 OF 21